


FIRST FLOOR

REGENCY CENTER II

±43,000 SF
FIRST FLOOR

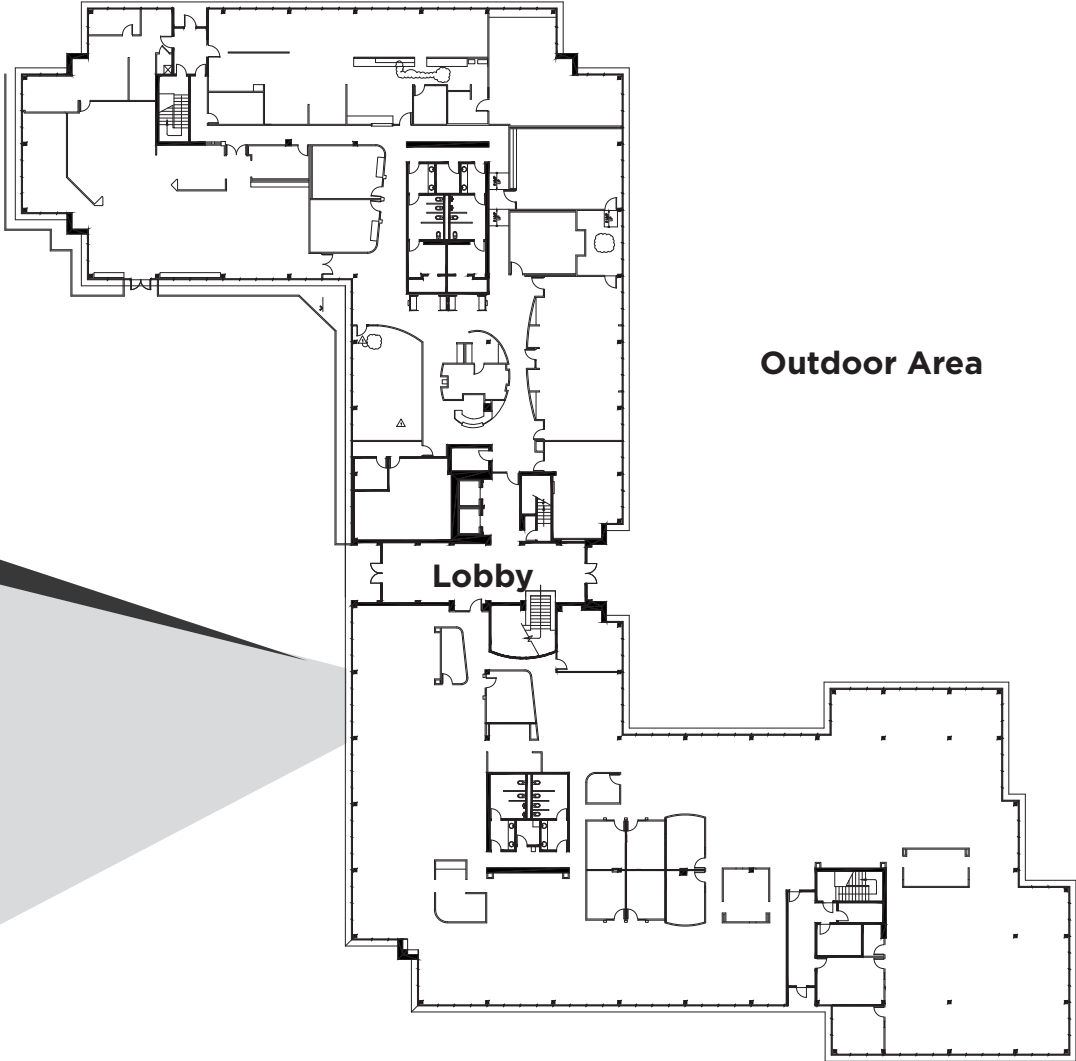

SUMMARY:

Large lobby entrance with direct exterior access. Currently configured with a conference center, large cafeteria and open spaces.

***Divisible to ±20,000 RSF**

As Built